



Document Comparison


Document A Resort Floor Plan

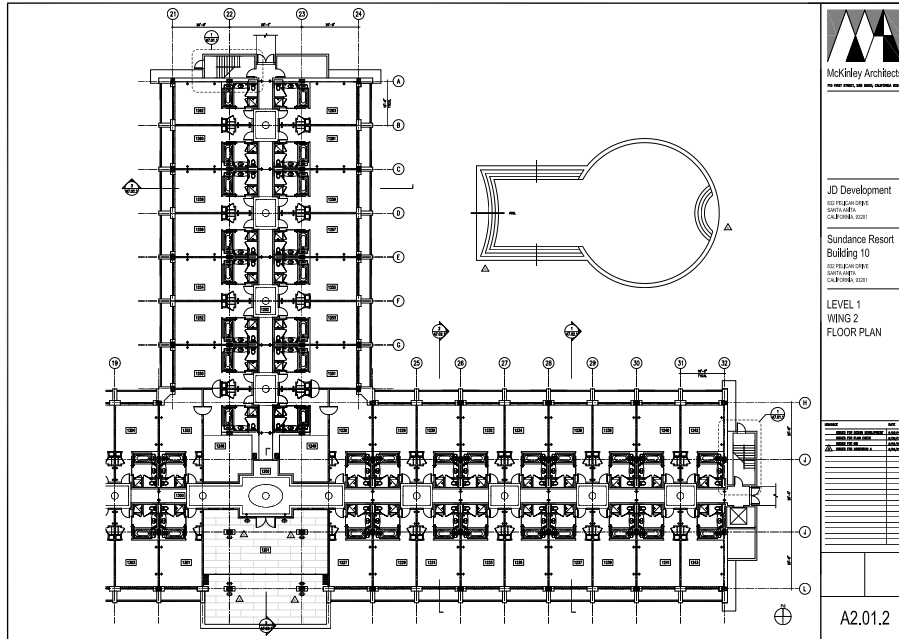


Document B Resort Floor Plan REVISED

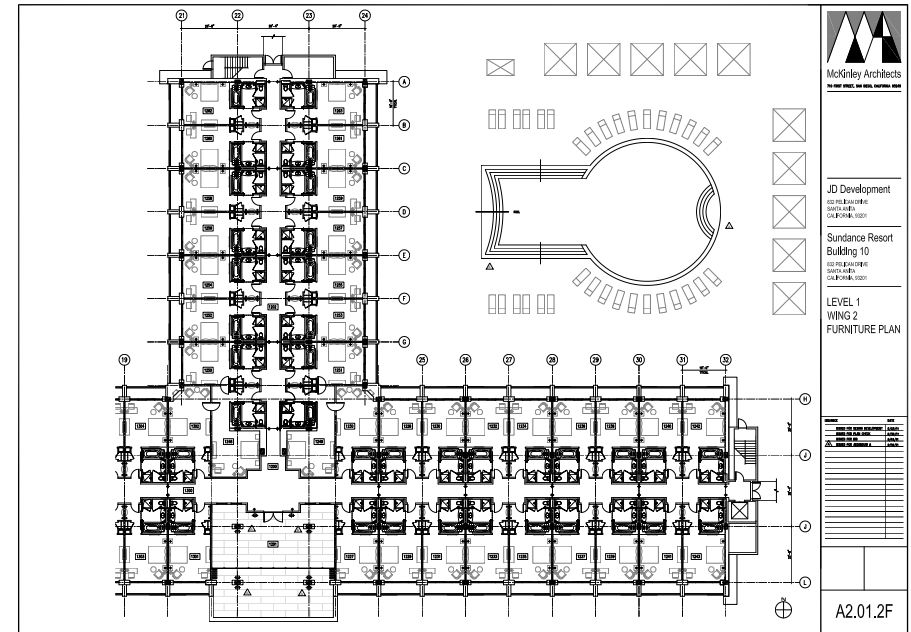

Bluebeam Revu will automatically compare multiple PDF drawings and mark the differences with clouds. From the **Document** menu, select **Compare Documents**. Click *Advanced* to adjust the level of sensitivity. For Multiple sheets, go to **File / Batch / Compare Documents**.

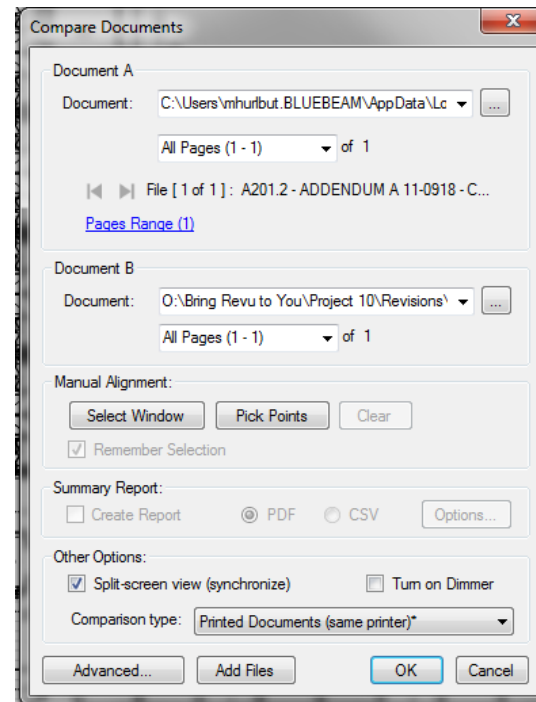


Differences shown from Document A to Document B

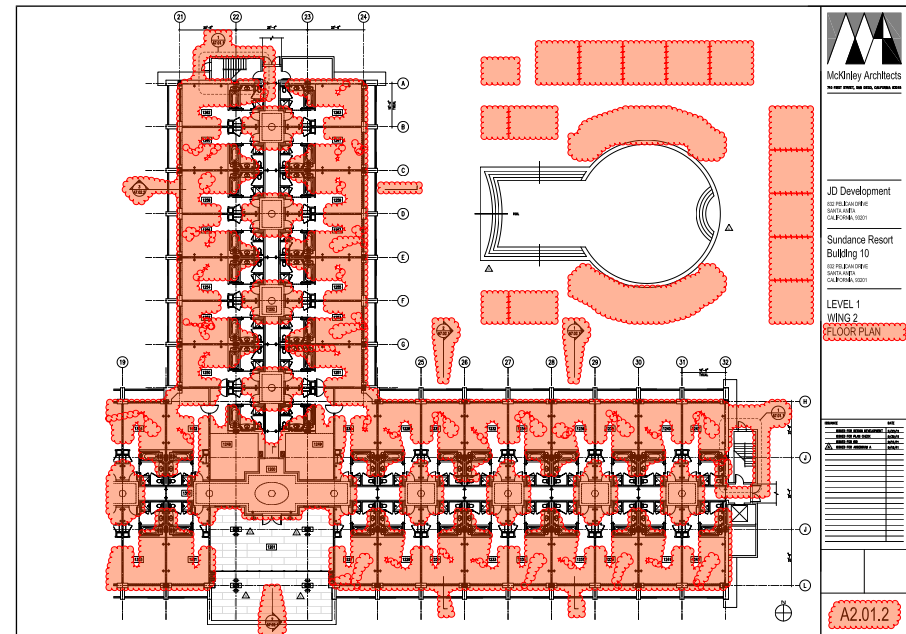

Document Comparison

Click through the **Markups List** tab and enter a description for each clouded revision under the **Comments** column. Export a **Summary** of the Markups List to an XML file which can be opened in Excel. Then issue the list together with the clouded drawings for a complete Bulletin, SI, LOC, or CWR revision.


Markups List Tab

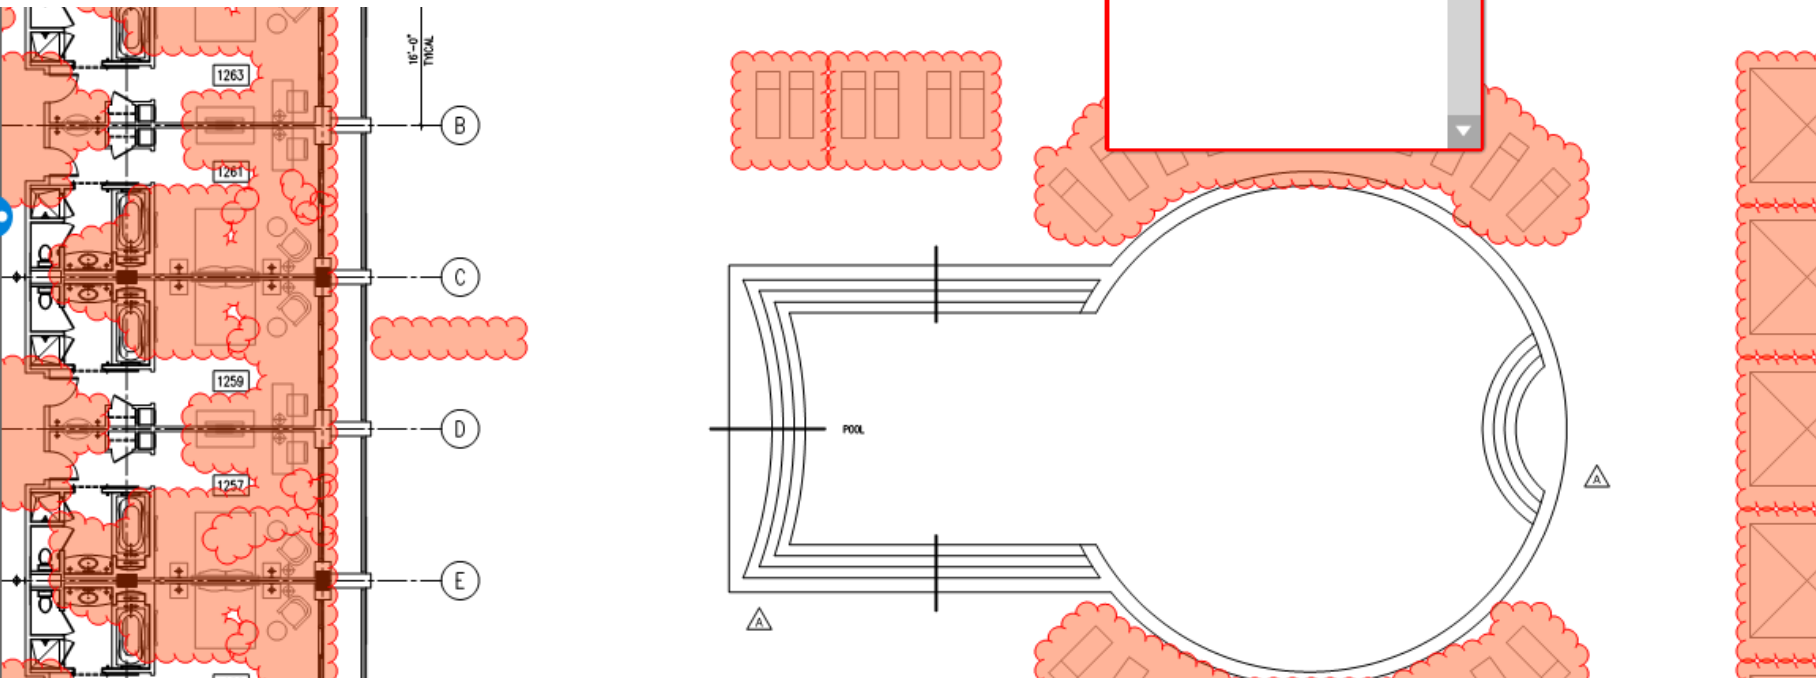

Subject	Page	Lock	Status	Checkmark	Author	Date	Color	Comments	Area	Count	Remarks
Difference	Page La...	<input type="checkbox"/>	None	<input type="checkbox"/>	mhurbut	4/9/20...	Red	Pool Chairs added			
Difference	Page La...	<input type="checkbox"/>	None	<input type="checkbox"/>	mhurbut	4/9/20...	Red	Towel kiosk added			
Difference	Page La...	<input type="checkbox"/>	None	<input type="checkbox"/>	mhurbut	4/9/20...	Red	Bathrooms made handicap accessible			
Difference	Page La...	<input type="checkbox"/>	None	<input type="checkbox"/>	mhurbut	4/9/20...	Red	Pool chairs added			
Difference	Page La...	<input type="checkbox"/>	None	<input type="checkbox"/>	mhurbut	4/9/20...	Red	Pool Chairs added			
Difference	Page La...	<input type="checkbox"/>	None	<input type="checkbox"/>	mhurbut	4/9/20...	Red	Cabana added			

Document Comparison

Overlay Pages allows you to compare different versions of the same PDF. Select two or more PDFs you want to compare by going to **Document / Overlay Pages**, and apply a different color to each. This will help identify the differences between the documents. Where there is no change between the two pages, the colors will blend to form a new, darker color. Since each page is added as a separate layer, you can control which page is displayed by turning layers on and off from the **Layers** tab.

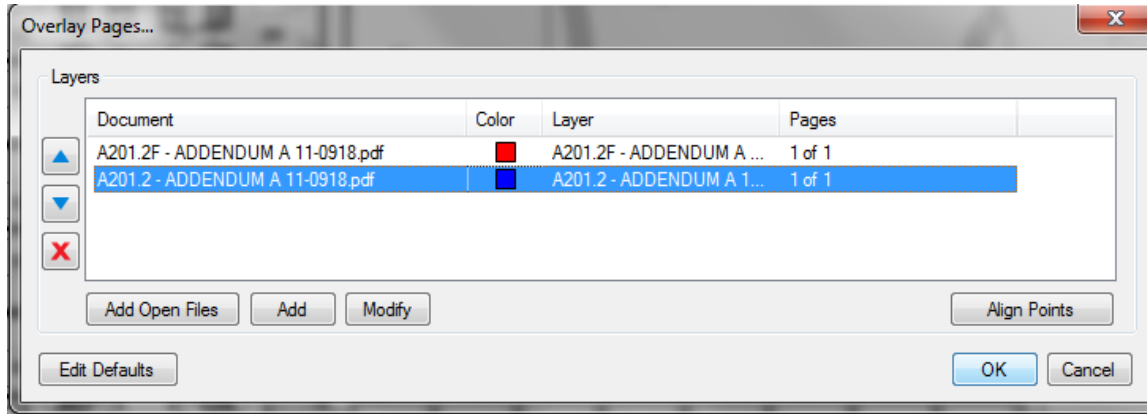

Align Points allows you to compare different versions of the same PDF that may be at different sizes, or may be skewed at different angles.

When in **Overlay Pages**, click *Align Points*. Follow the screen instructions to choose three identical points on each document. This will allow the documents to line up seamlessly.

